


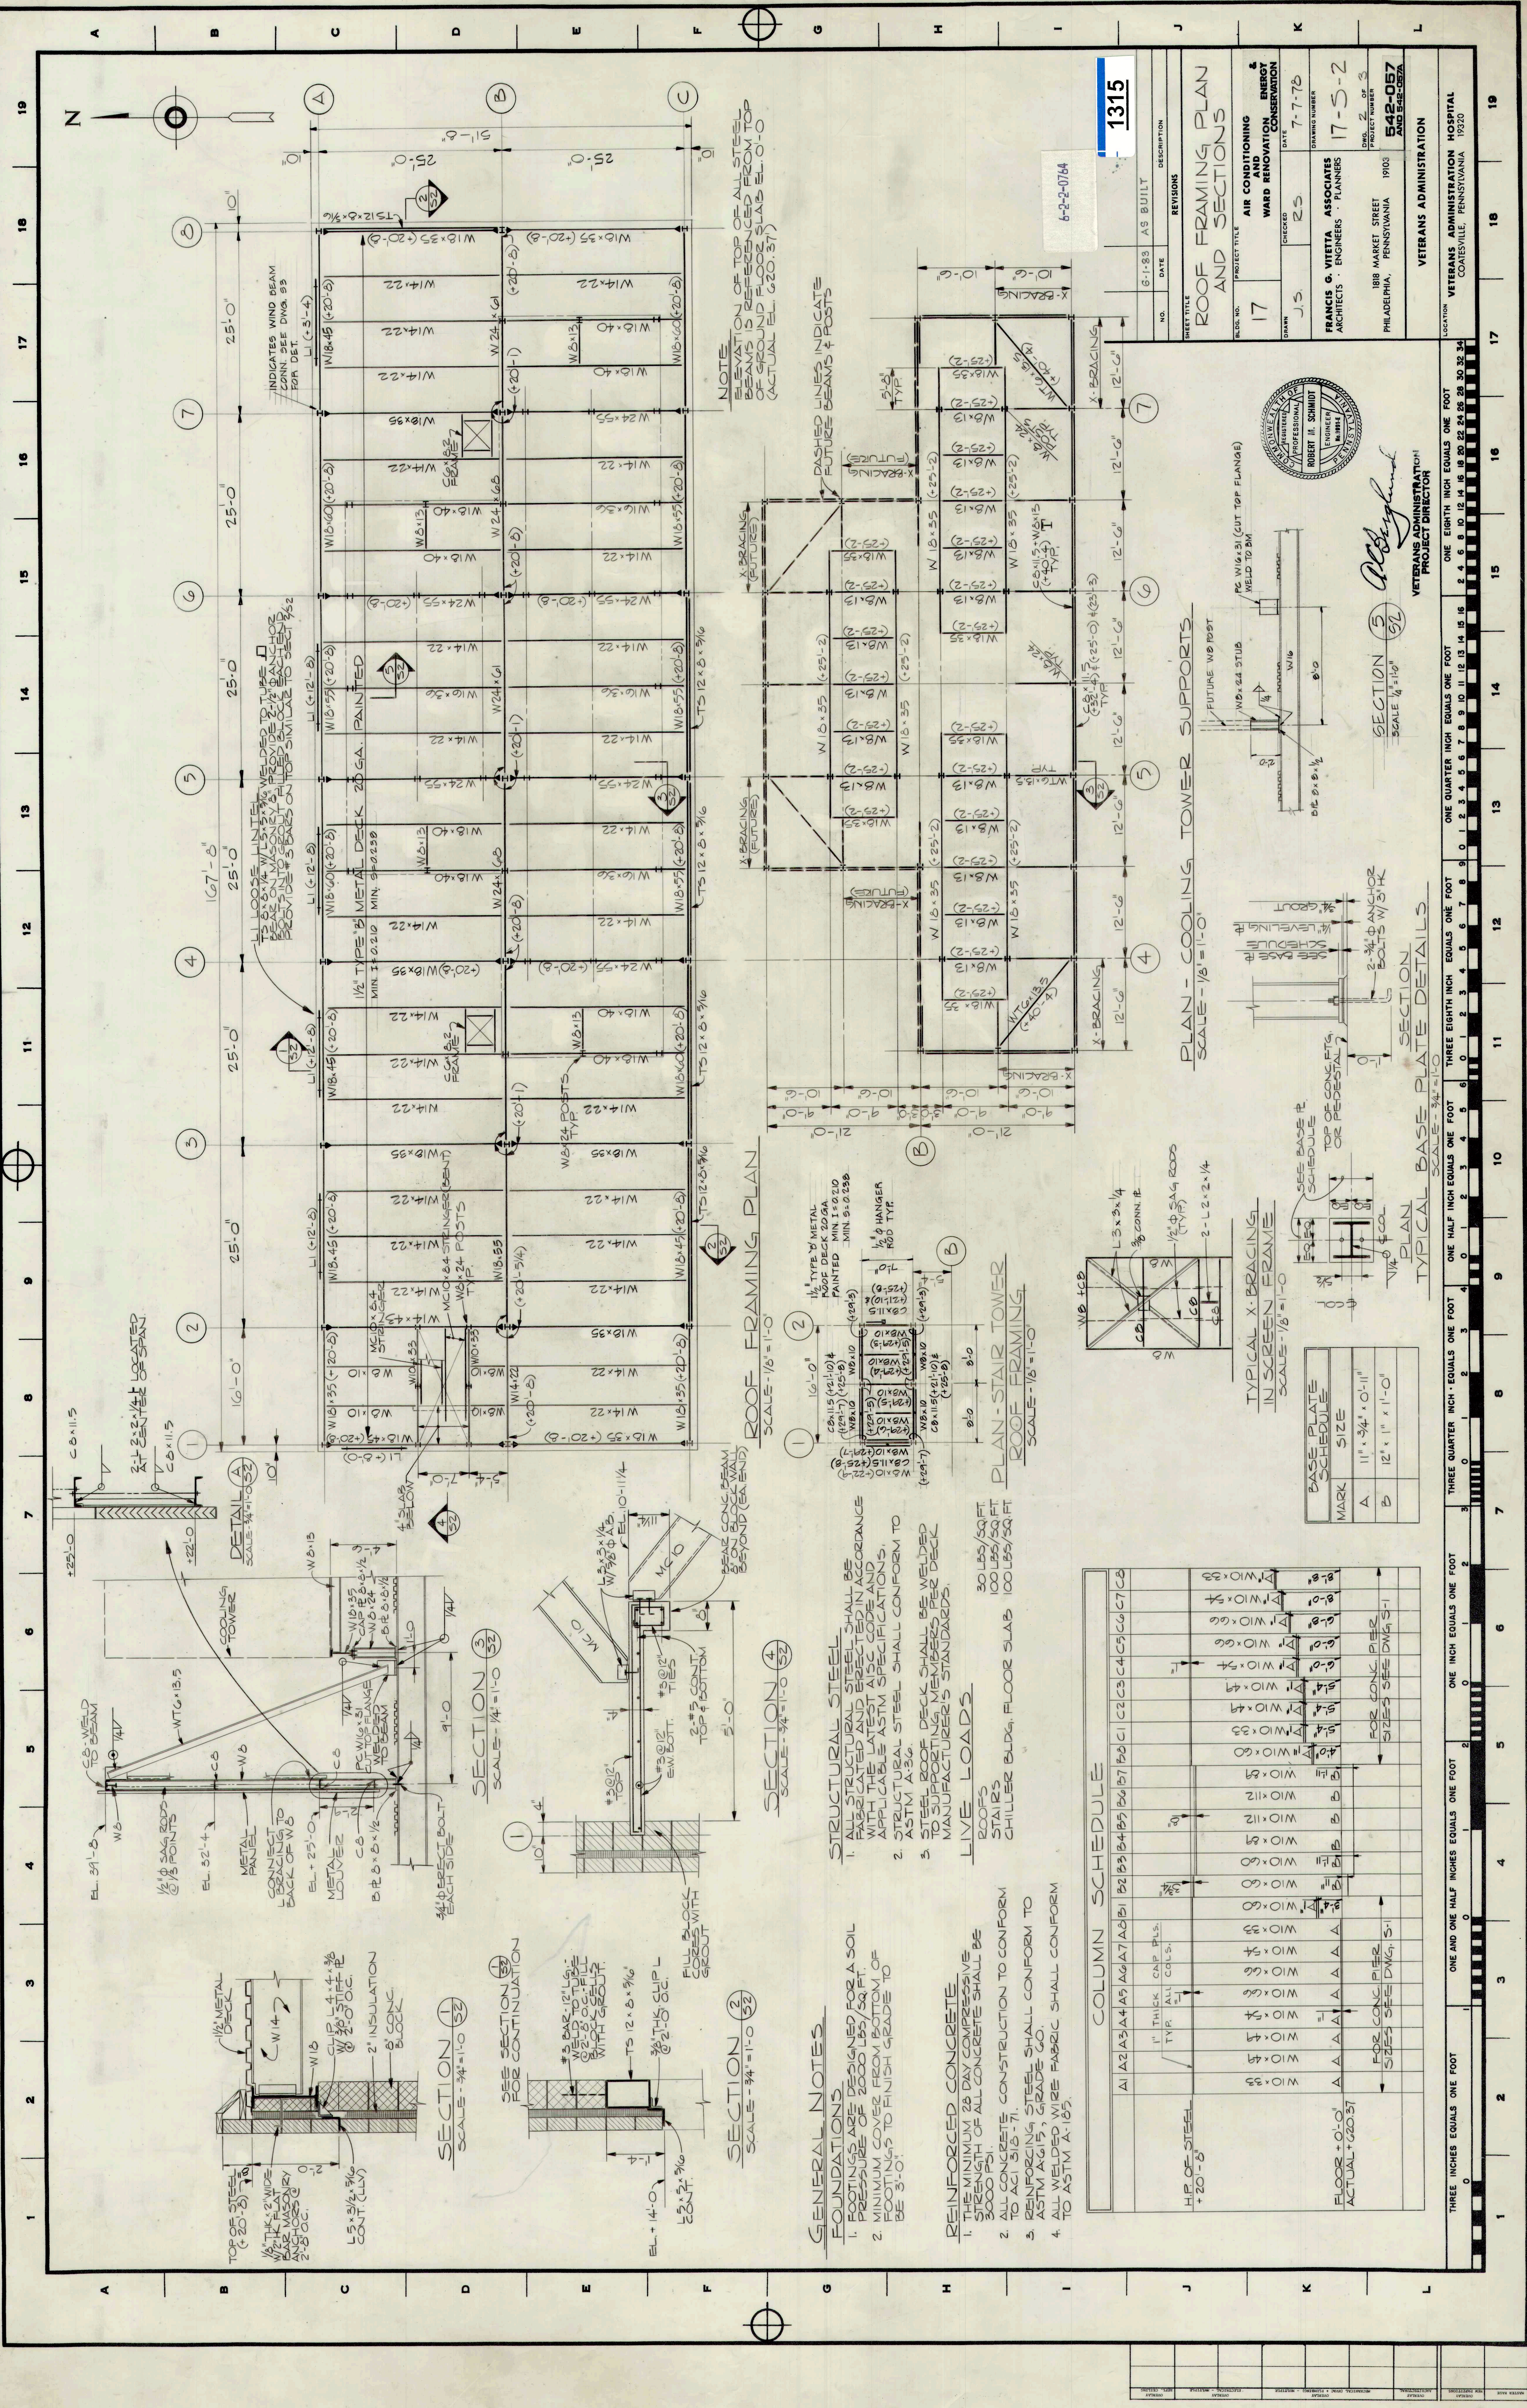

REVISIONS		DATE	DESCRIPTION
NO.	DATE	AS BUILT	
PROJECT TITLE			
ROOF FRAMING PLAN AND SECTIONS			
PROJECT NO.			
17			
DRAWN			
J.S.			
CHECKED			
25			
DATE			
7-7-78			
PROJECT NUMBER			
17-5-2			
DRAWING NUMBER			
542-057			
PROJECT NAME			
VETERANS ADMINISTRATION HOSPITAL			
LOCATION			
COATESVILLE, PENNSYLVANIA 19320			

PROJECT TITLE		PROJECT NO.	
ROOF FRAMING PLAN AND SECTIONS		17	
DRAWN		J.S.	
CHECKED		25	
DATE		7-7-78	
PROJECT NUMBER		17-5-2	
DRAWING NUMBER		542-057	
PROJECT NAME		VETERANS ADMINISTRATION HOSPITAL	
LOCATION		COATESVILLE, PENNSYLVANIA 19320	

